



**NOTES:**  
Do not scale from this drawing:  
work to figured dimensions only.  
All information to be checked  
on site for accuracy and fit.


Front view  
scale 1:20

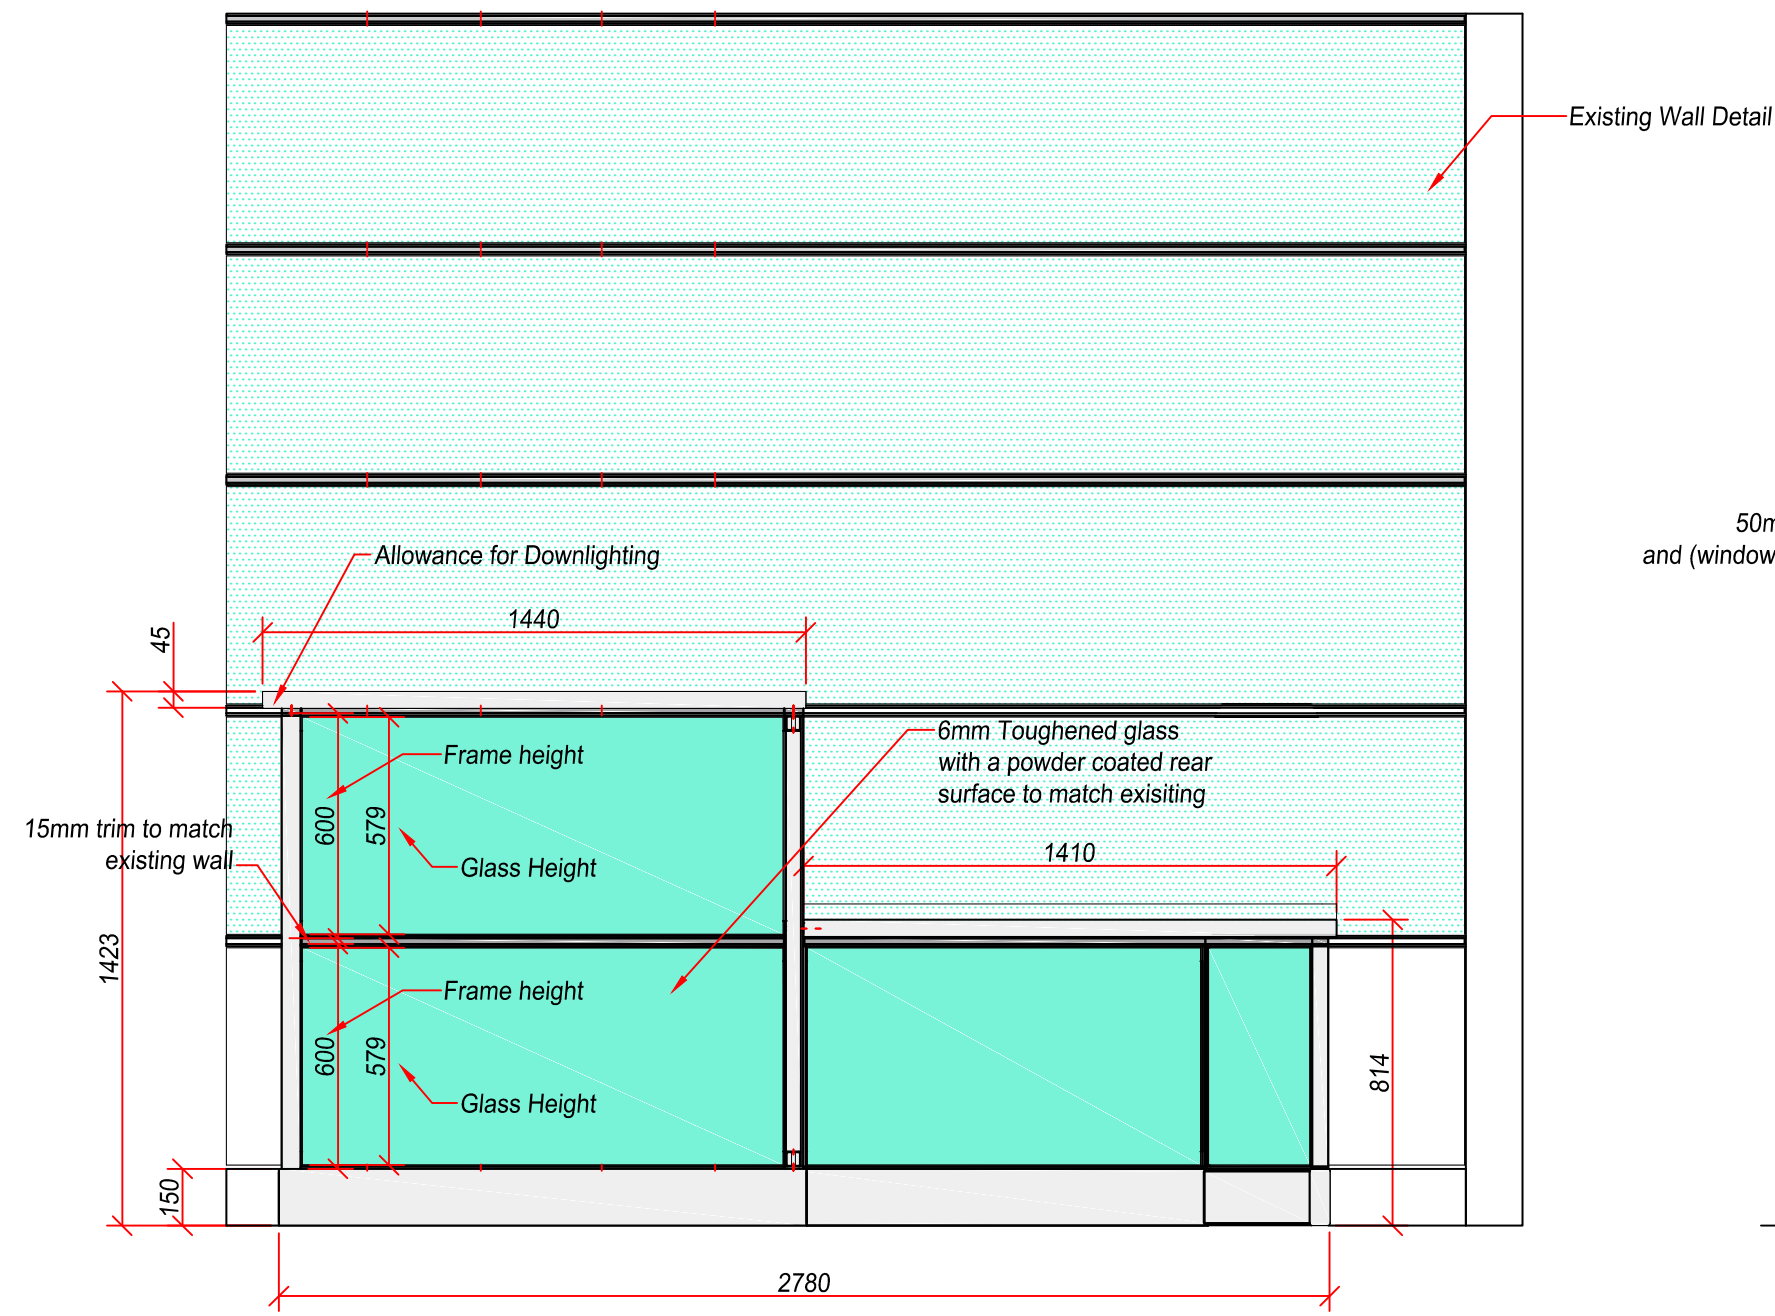


Side View  
scale 1:20

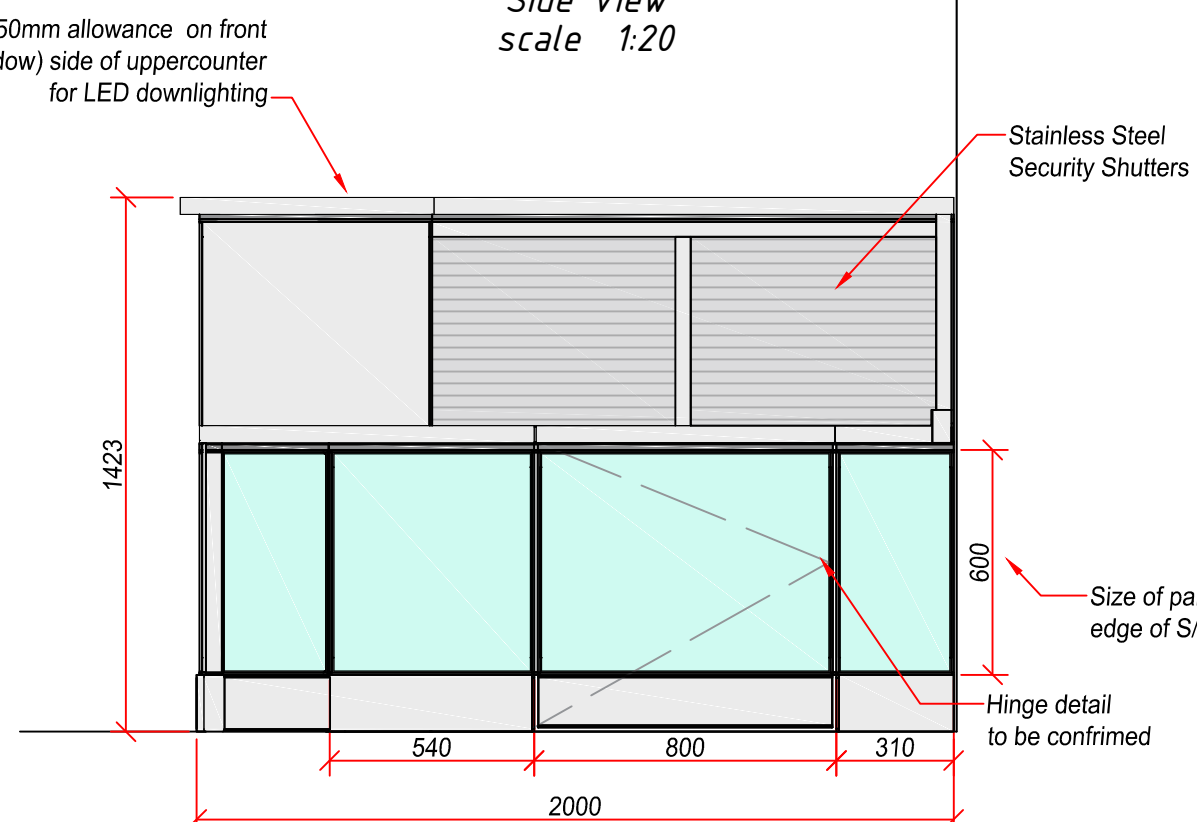


Plan View  
scale 1:20

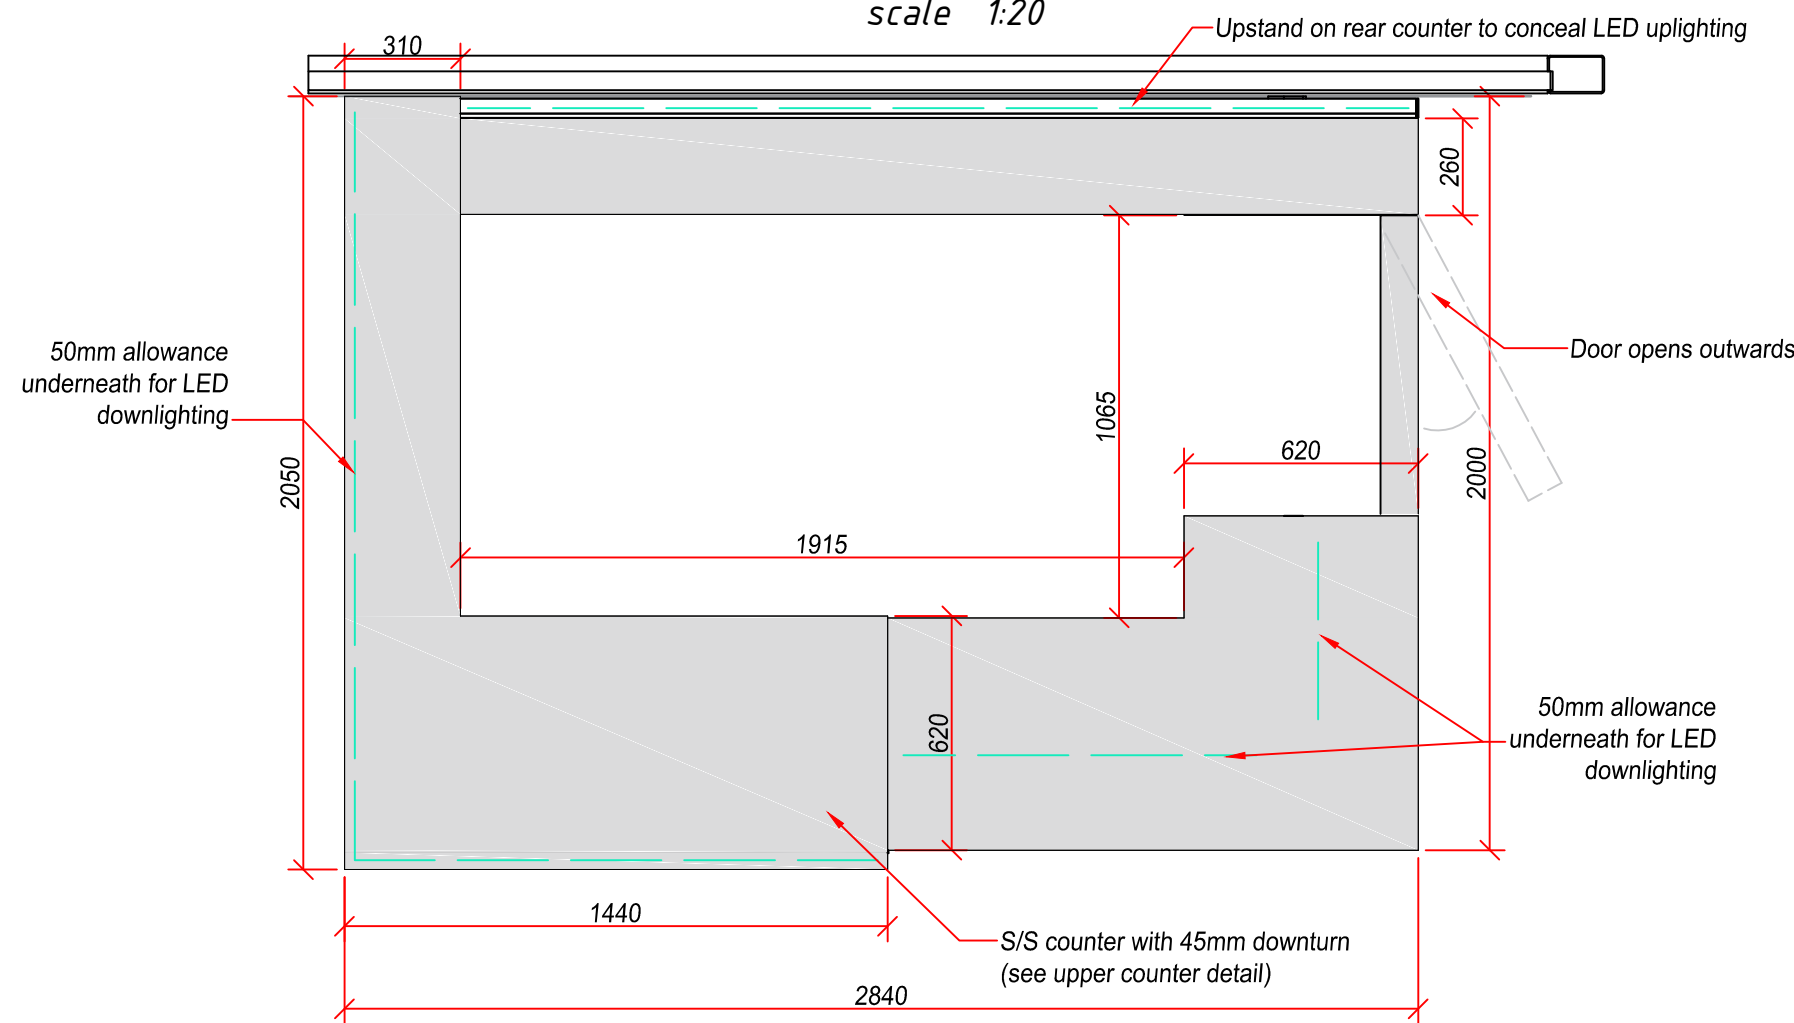


P1 Plan View  
scale 1:15

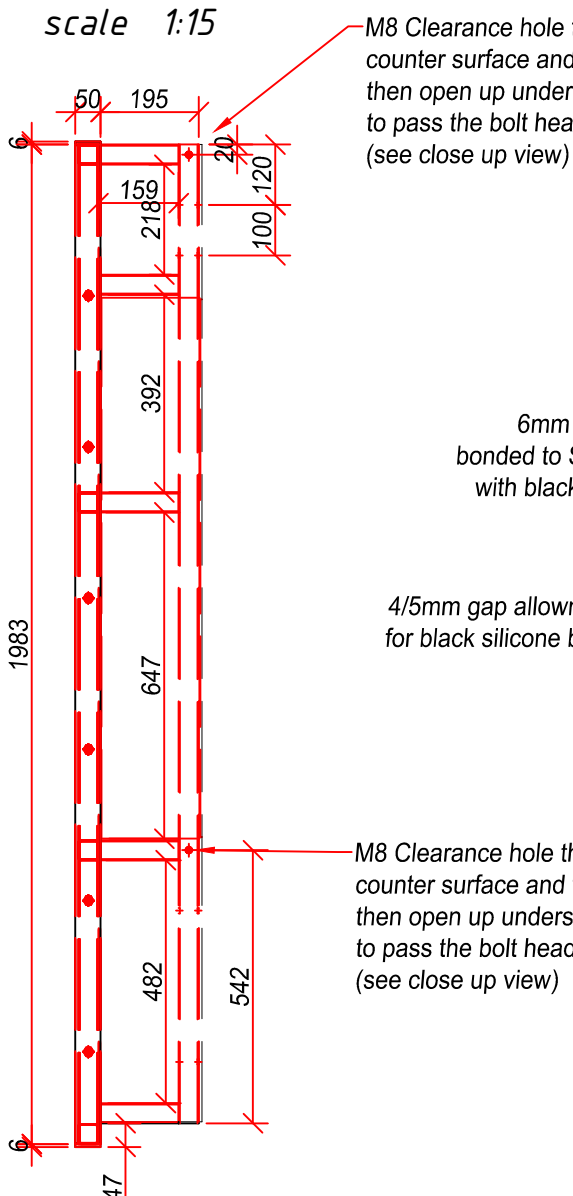


Close up view of components

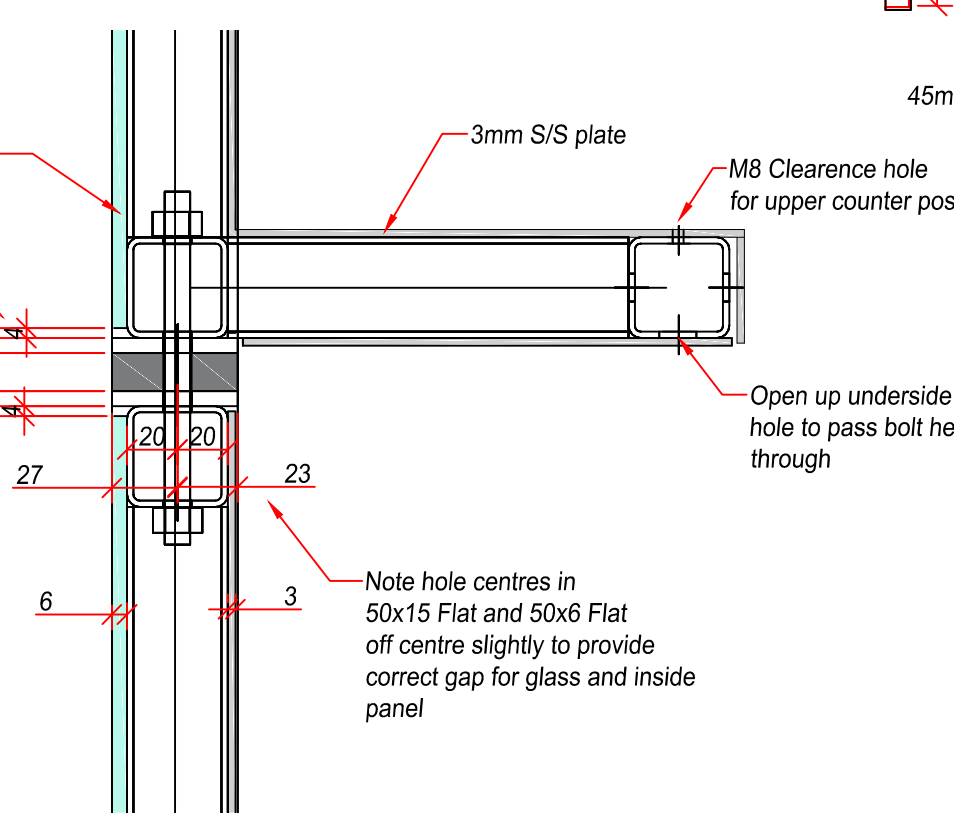


Upper Counter Frame - Detail 1  
scale 1:20

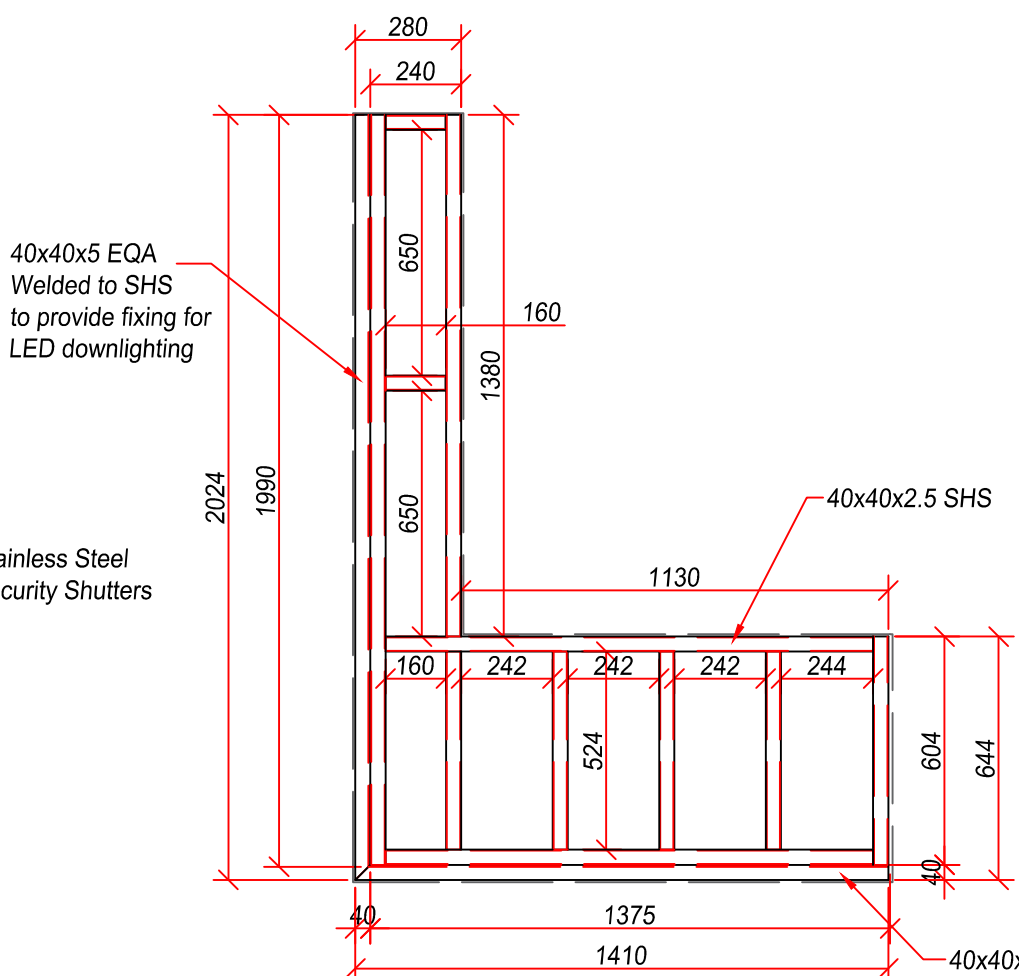


Upper Counter -detail 2  
scale 1:20

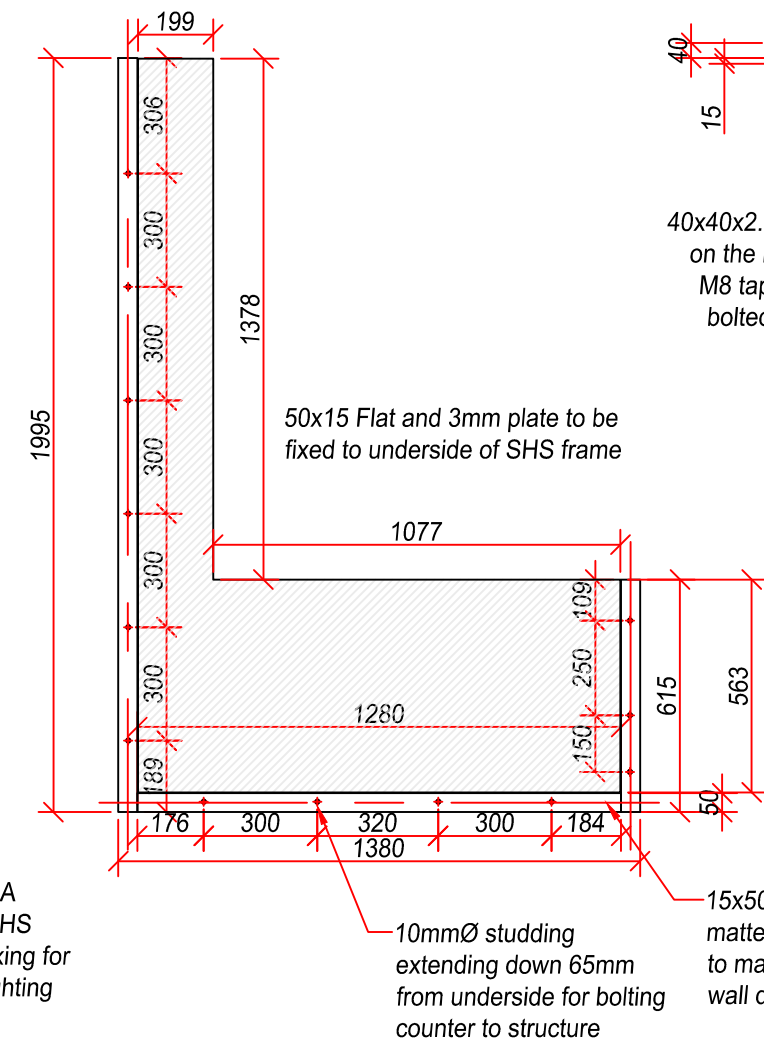


Upper Counter Structure - Side View  
scale 1:20

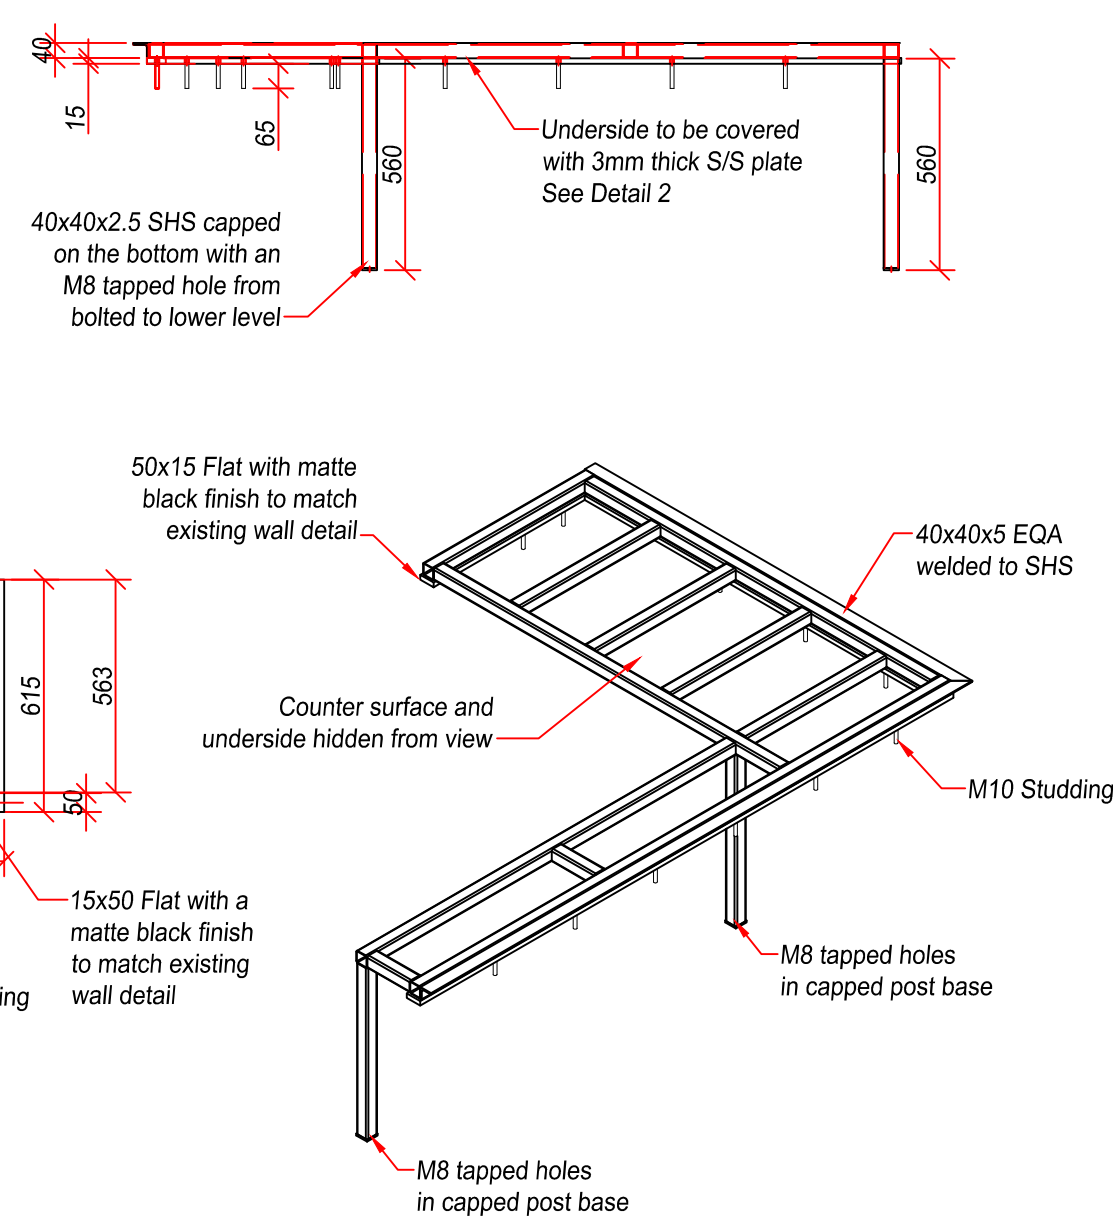


Skirting Detail (D3)  
scale 1:20

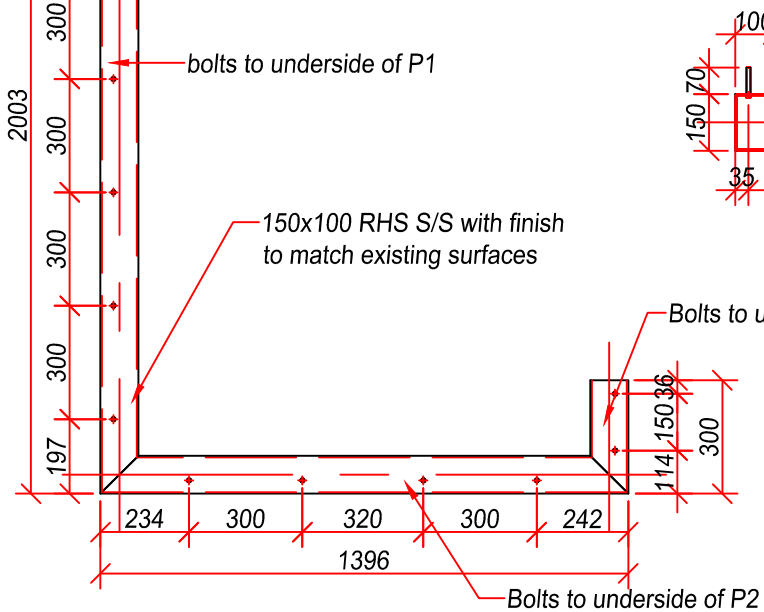


Skirting Detail Front View  
scale 1:20

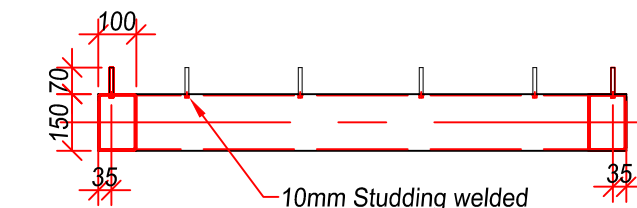


P1 Panels Front view  
scale 1:15

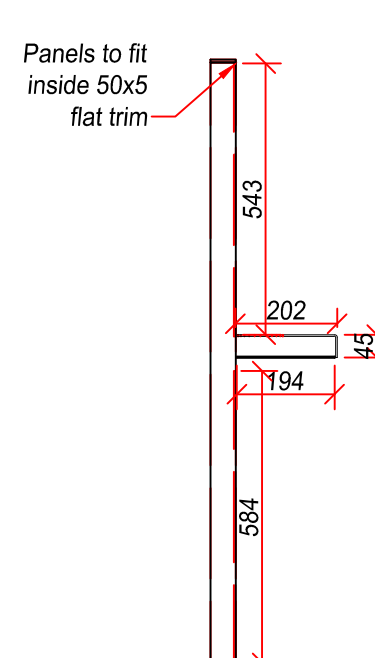


P1 Panel View  
scale 1:15

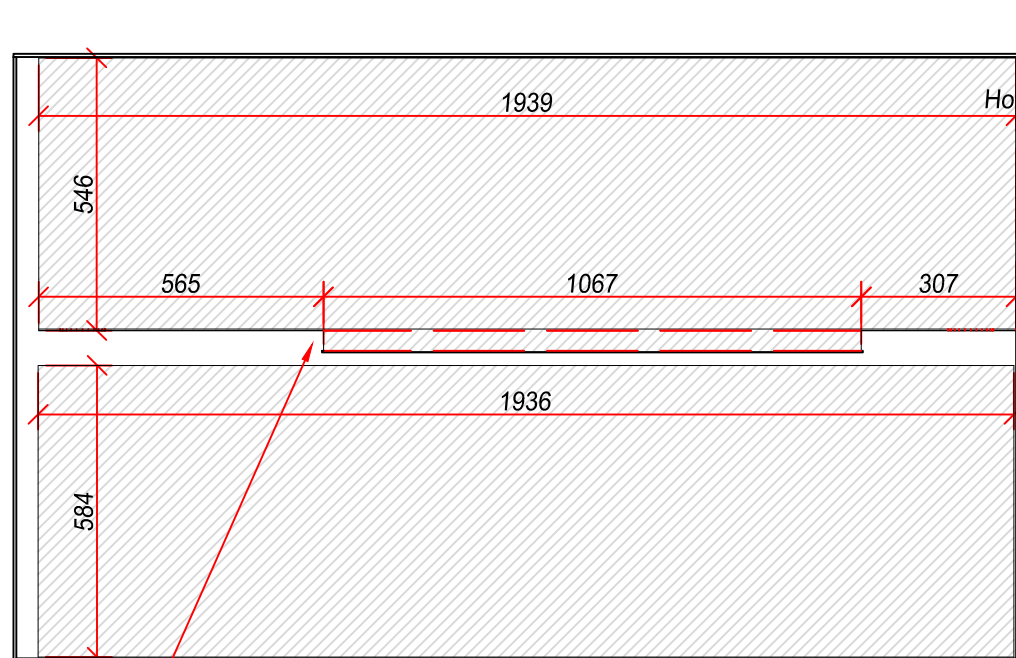

P1 Front View  
scale 1:20

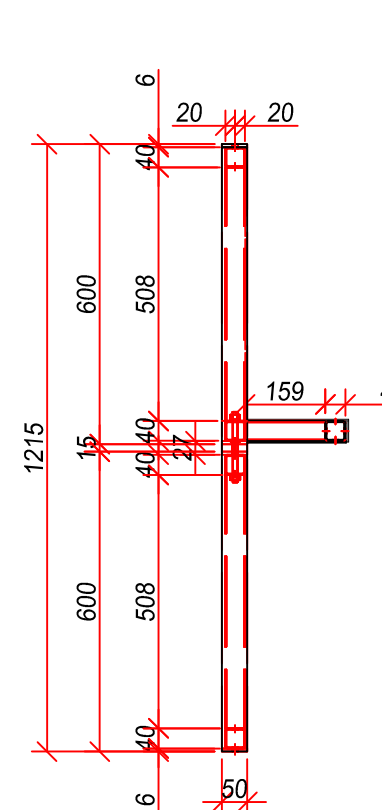

P1-Side View (From Inside)  
scale 1:15

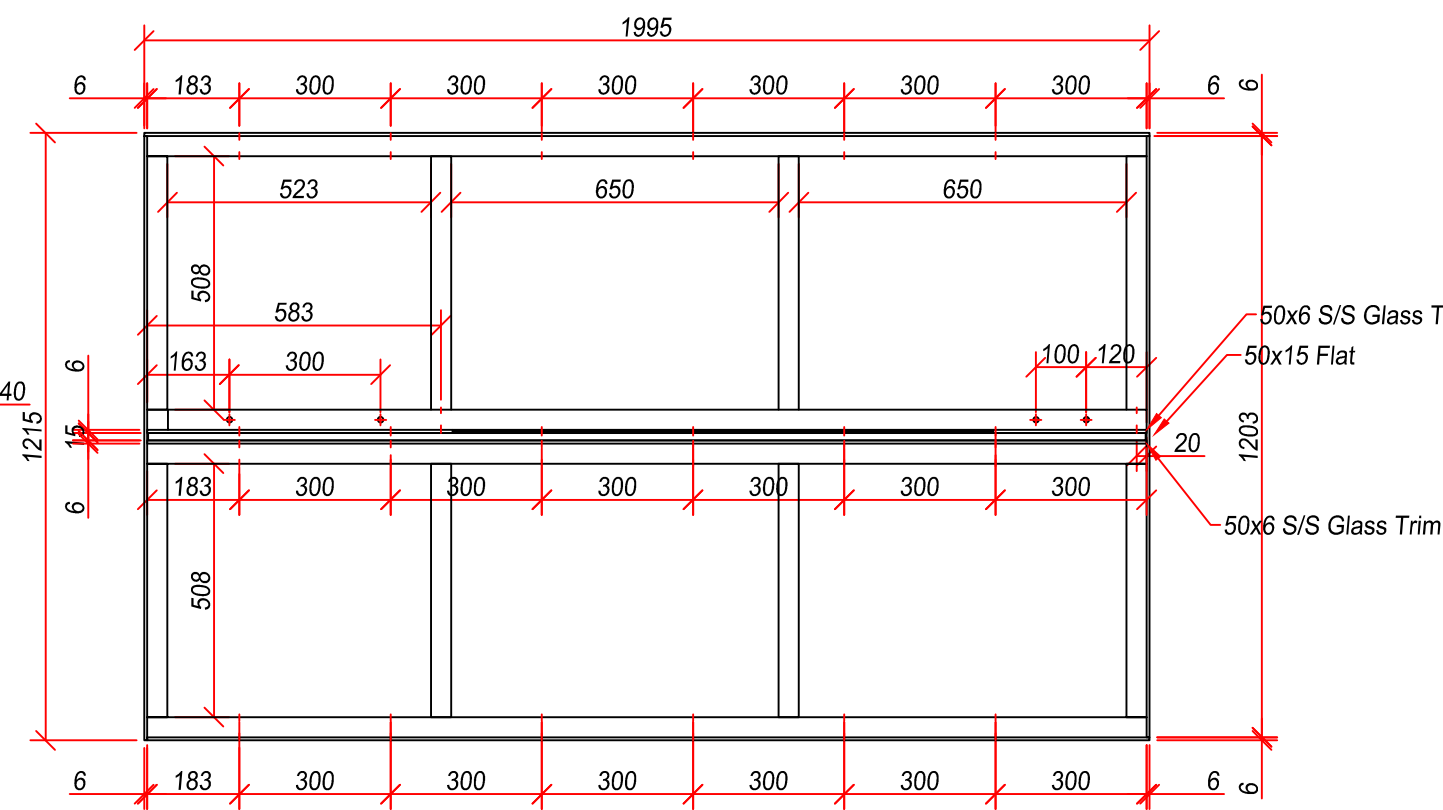

Rev	Date	Description	By
AB1	14/01/20	As Built	ST
001	20/08/19	First Issued	ST

**SRT DESIGN SERVICES**  
t: 01587 162333 e: srt@designservices.co.uk

**Tate Technical**  
Tel: 02393 162333










Project  
**St Pancras Station Information Desk**

Drawn By	1:1	Date	14/01/2020
Scale	N/T	By	ST

GA View and Upper Counter and P1 Detail


Drawing No	Revision
SRT-3530-AB1	AB1



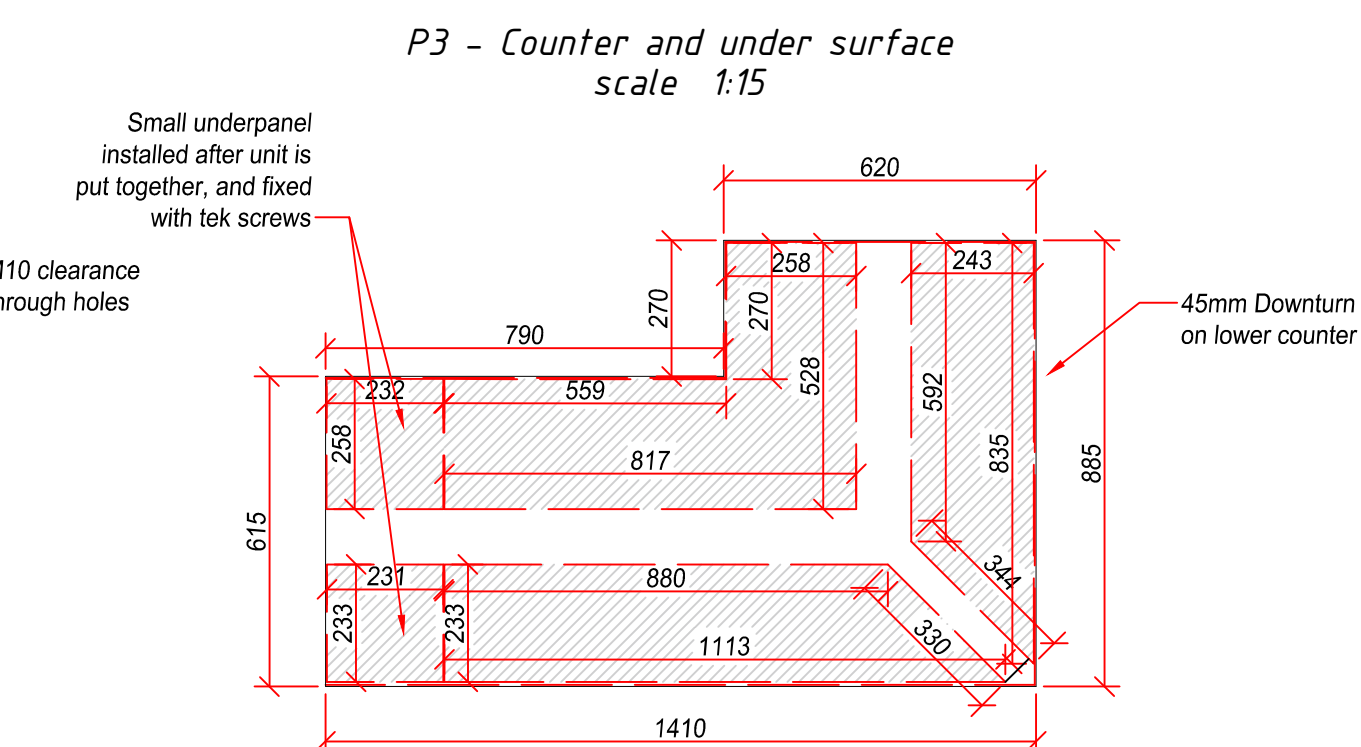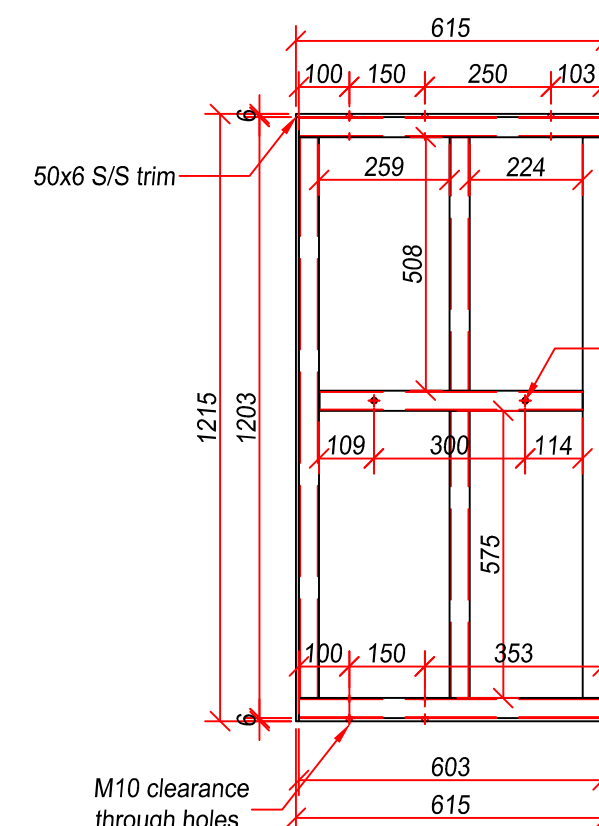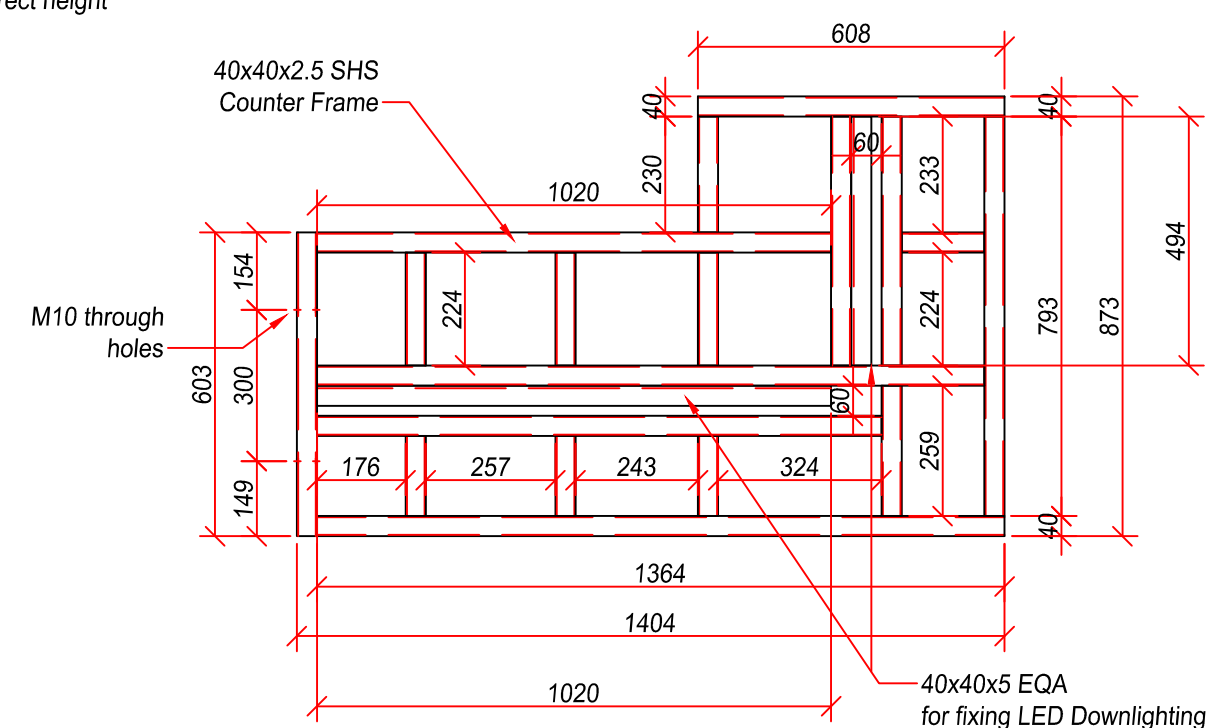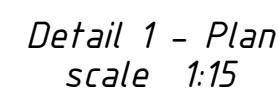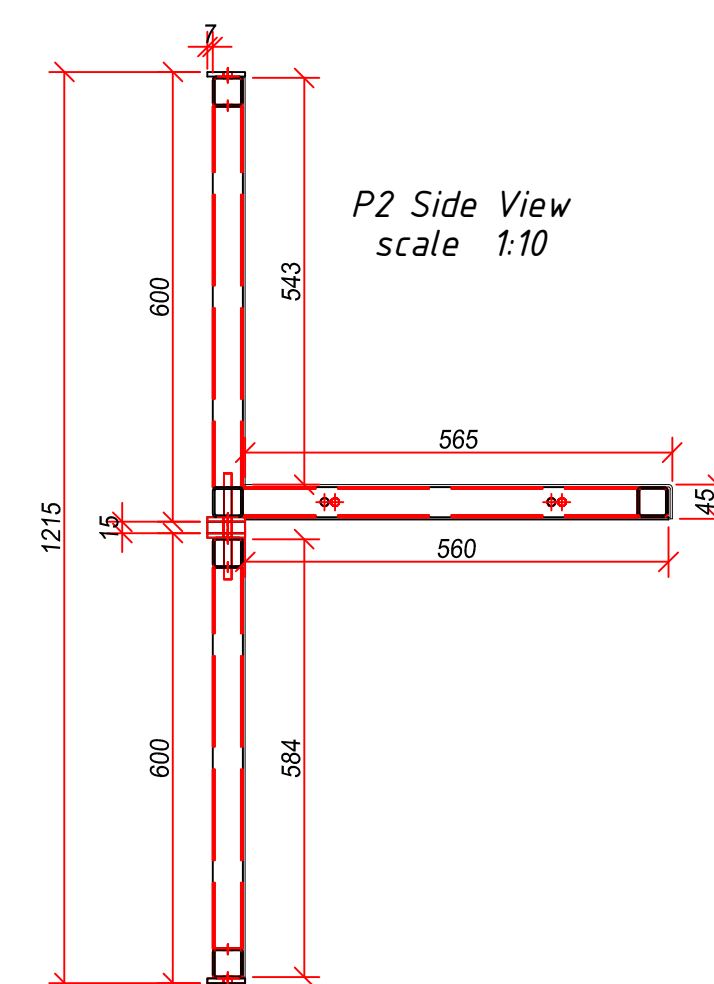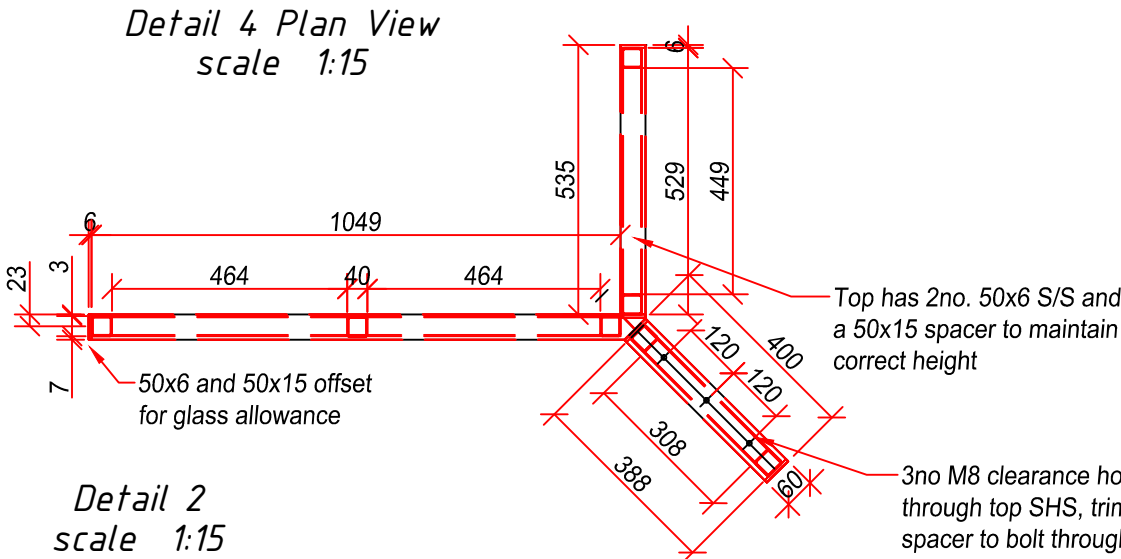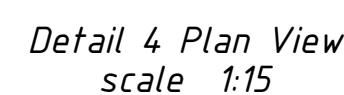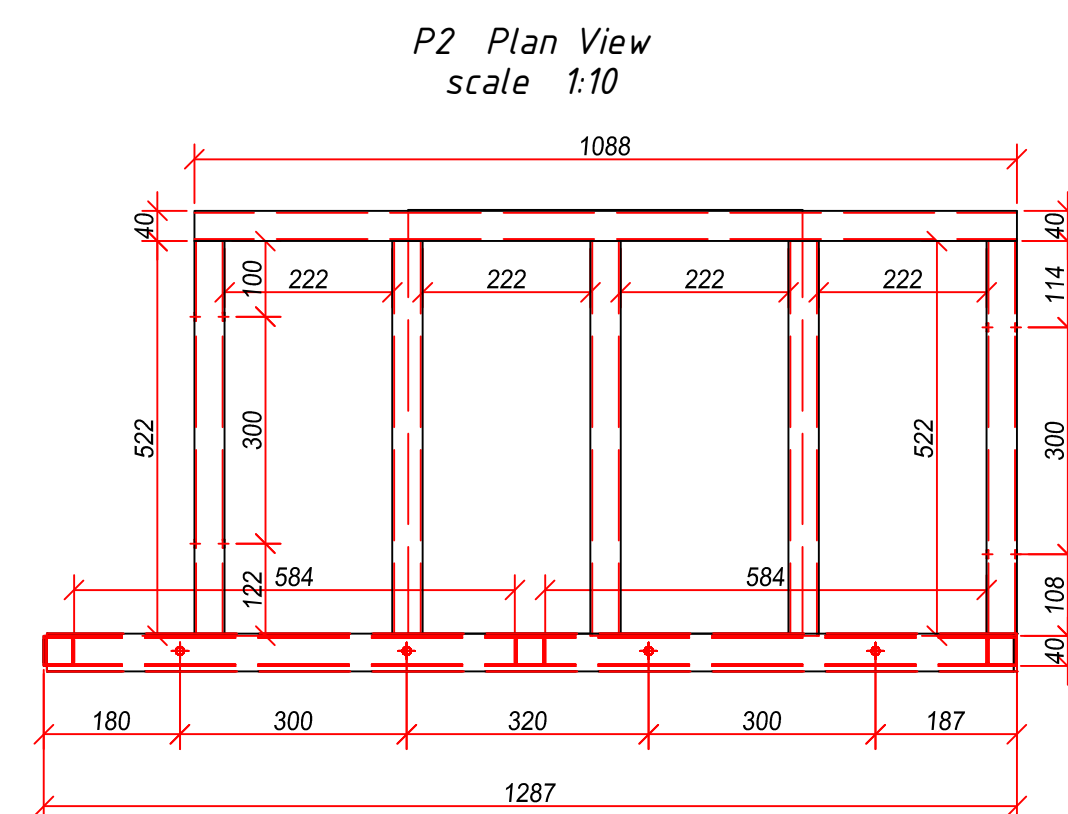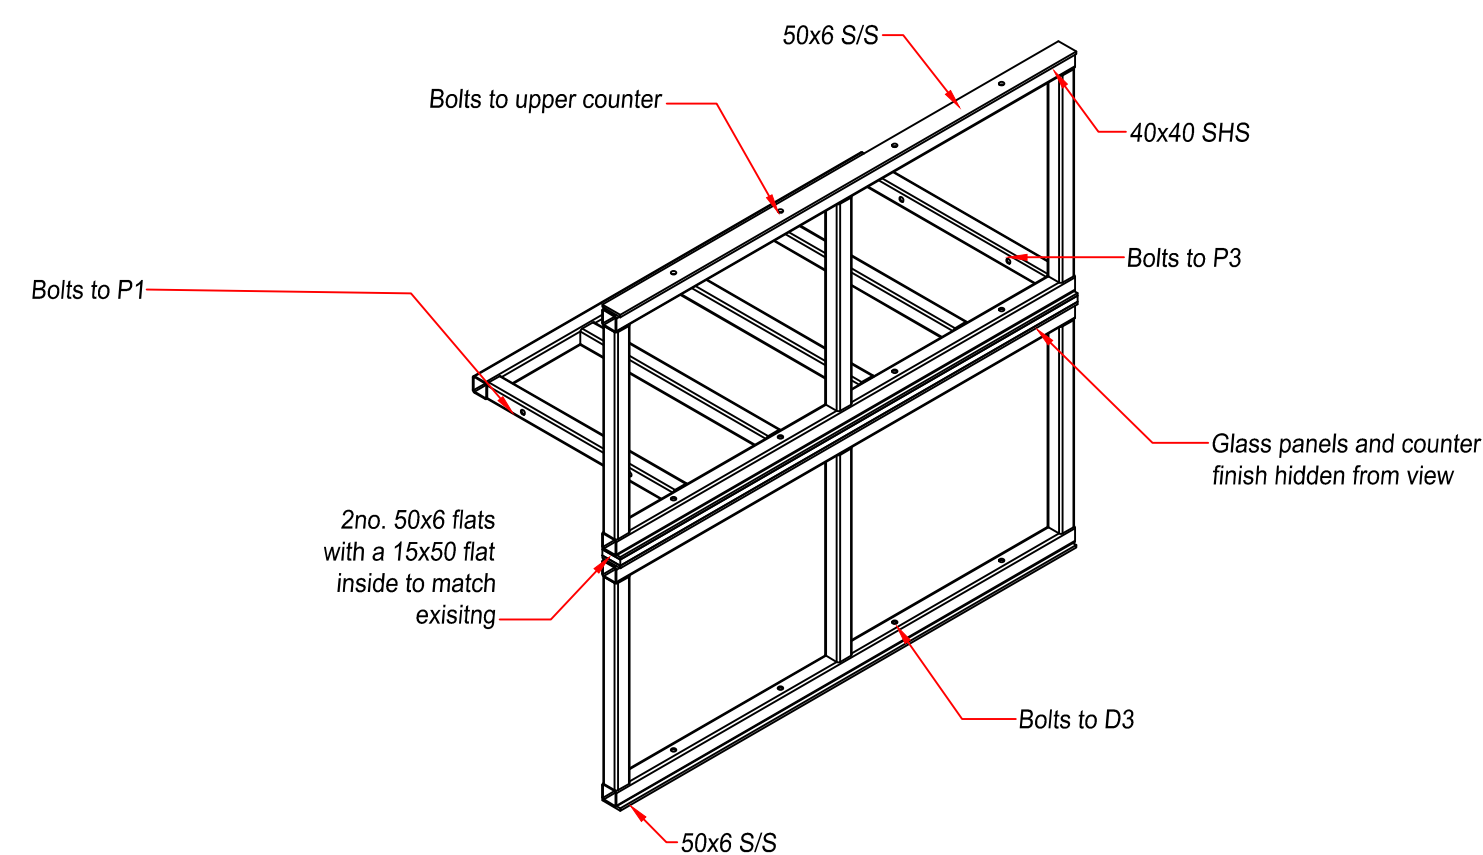

Drawing No	Revision
SRT-3531-AB1	AB

NOTES:  
Do not scale from this drawing;  
work to figured dimensions only.  
All information to be checked  
on site for accuracy and fit.

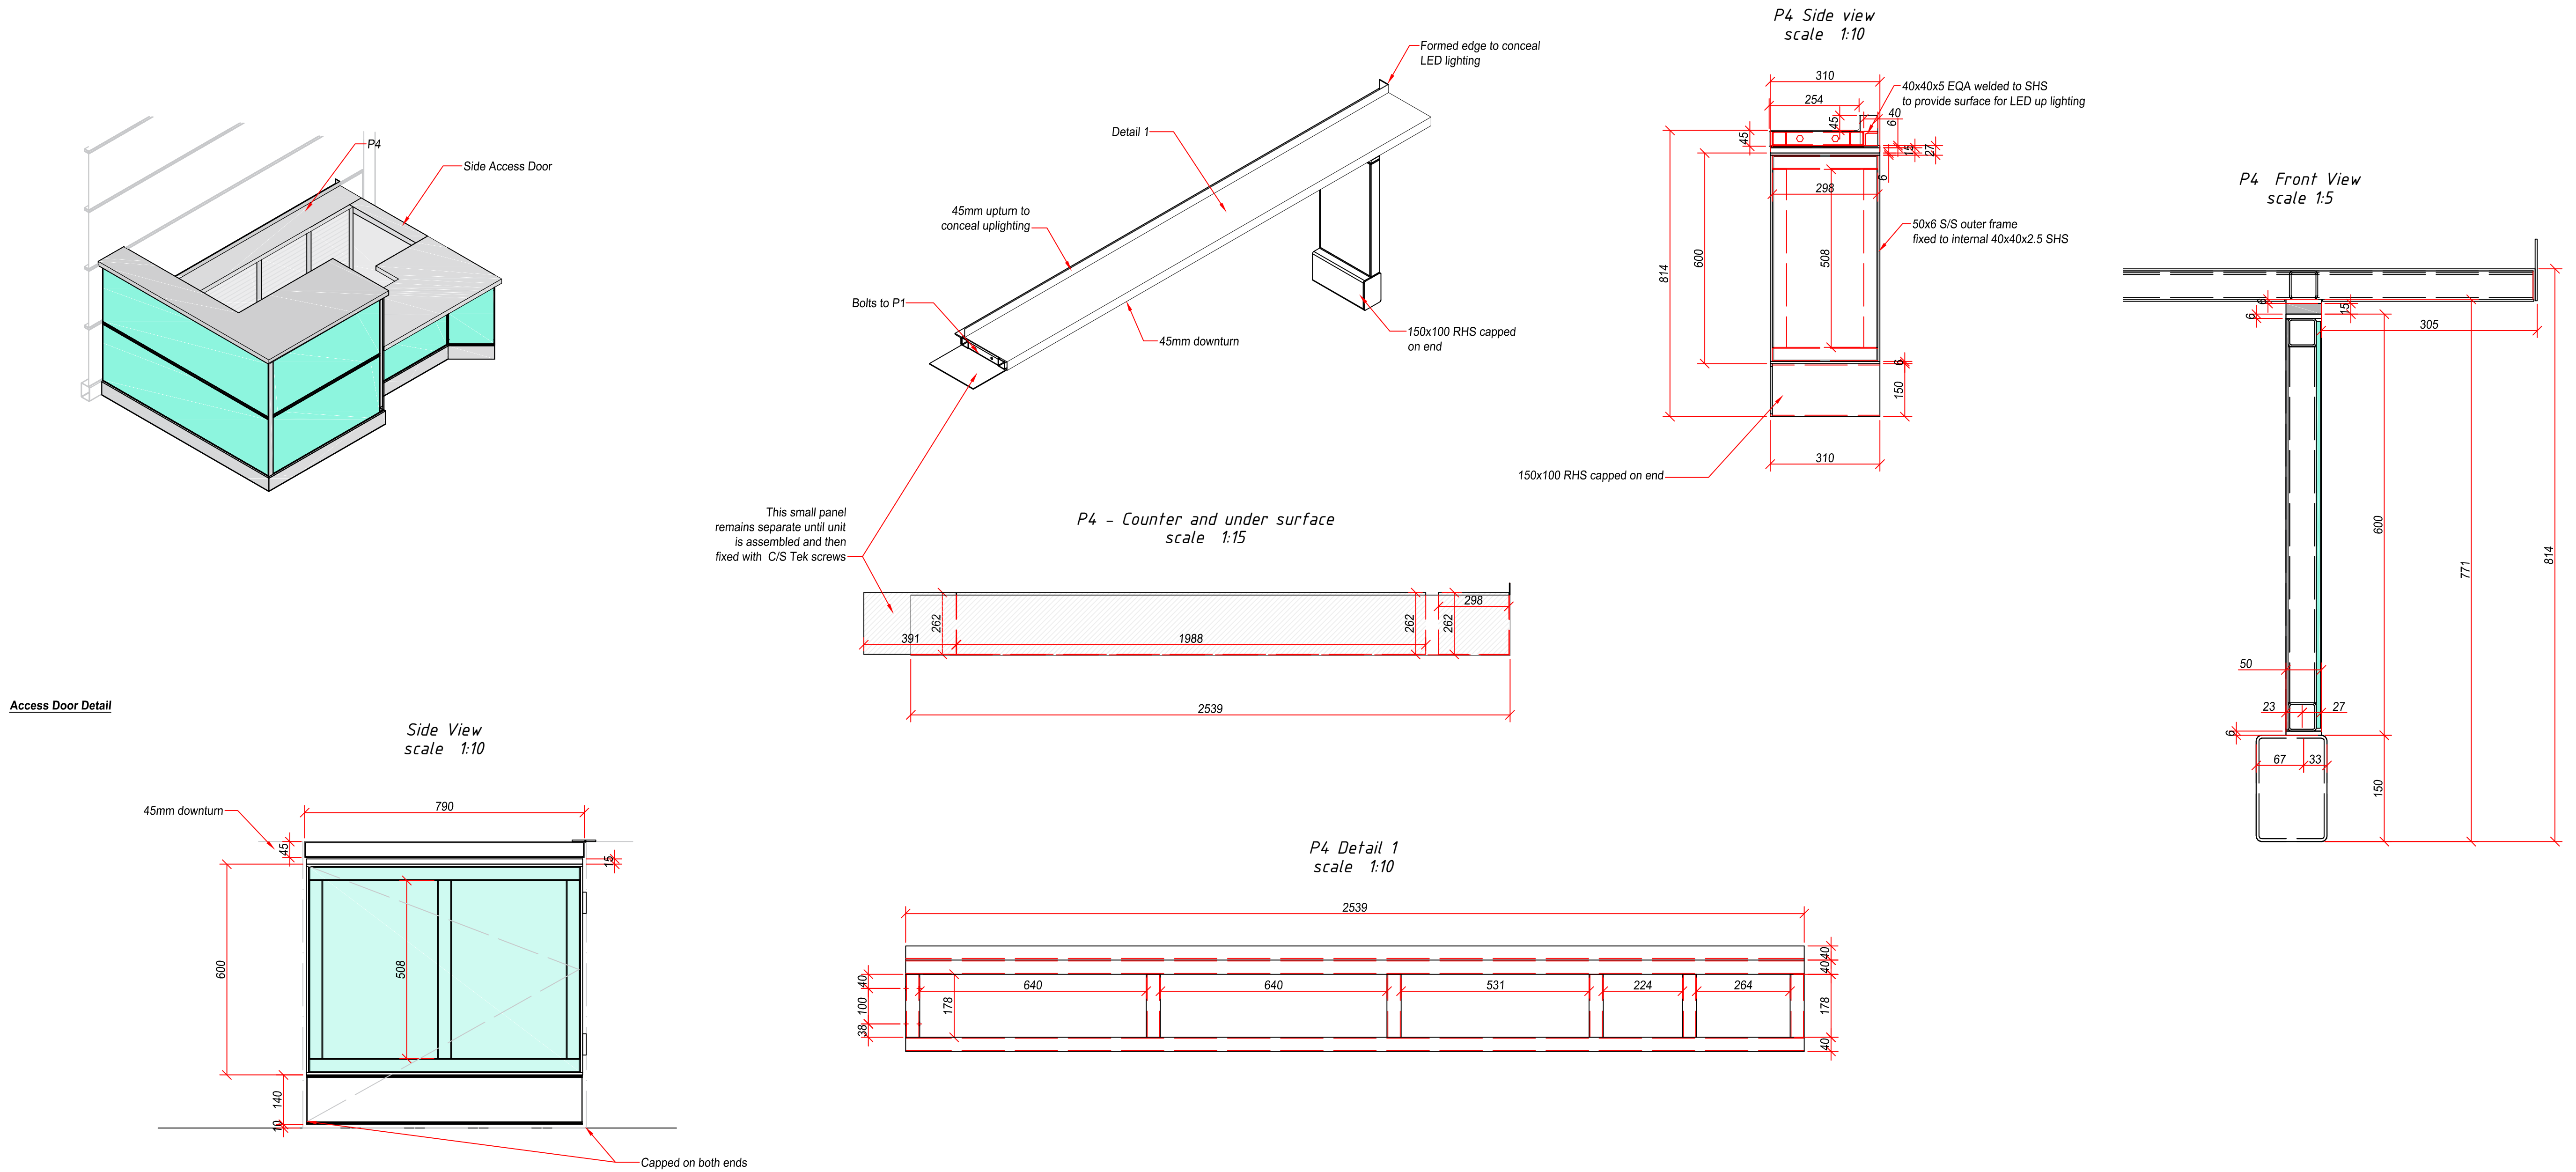

Rev	Date	Description	By
AB1	14/01/20	As R/1	ST

**SRT DESIGN SERVICES**  
t: 02393 162333 e: srt@signtech.co.uk



Project  
**St Pancras Station  
Information Desk**

Drawn By	ST
Date	14/01/2020
Scale	NTS
Drawing Title	AB1

P4 - Access Door and rear counter

Drawing No	Revision
SRT-3532-AB1	AB1